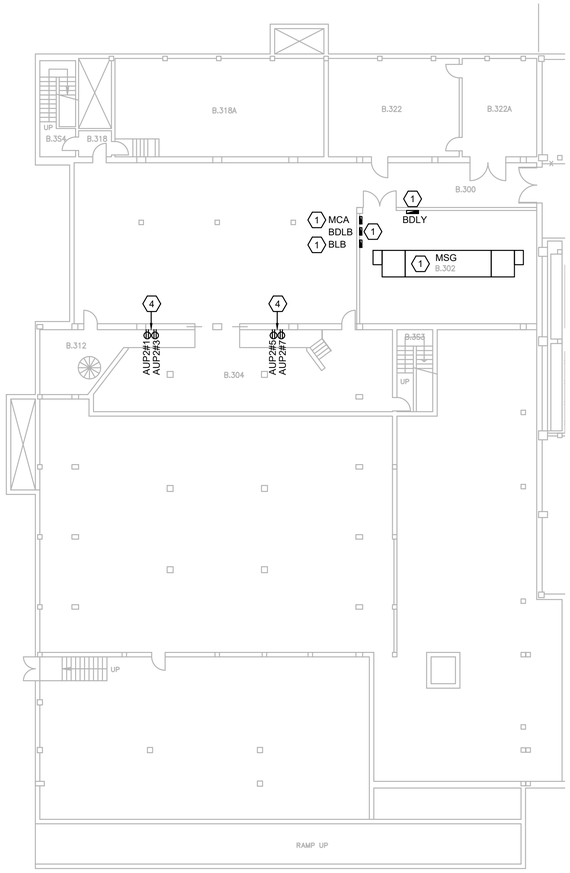


## 1 POWER PLAN - BASEMENT

1/16" = 1'-0"

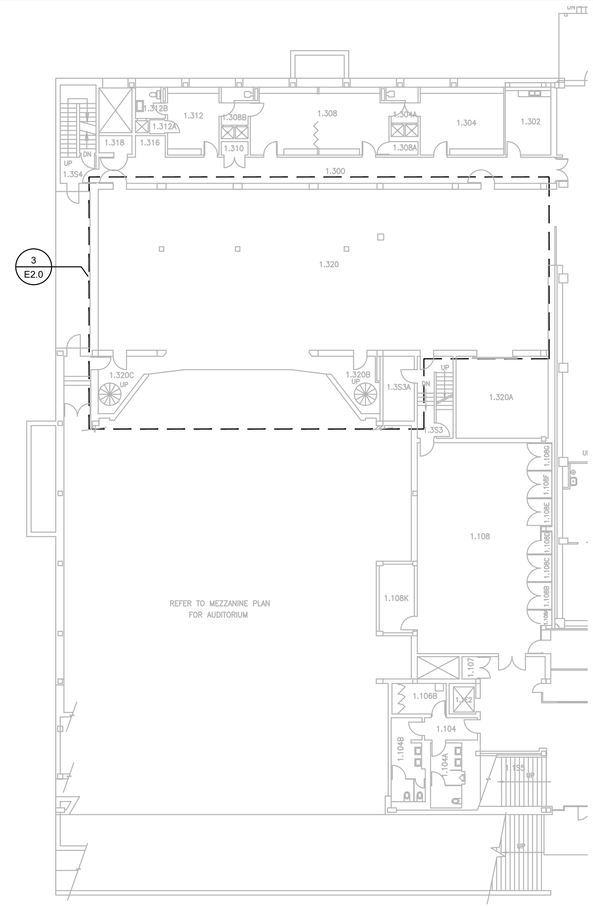


## 2 POWER PLAN - 1ST FLOOR

1/16" = 1'-0"

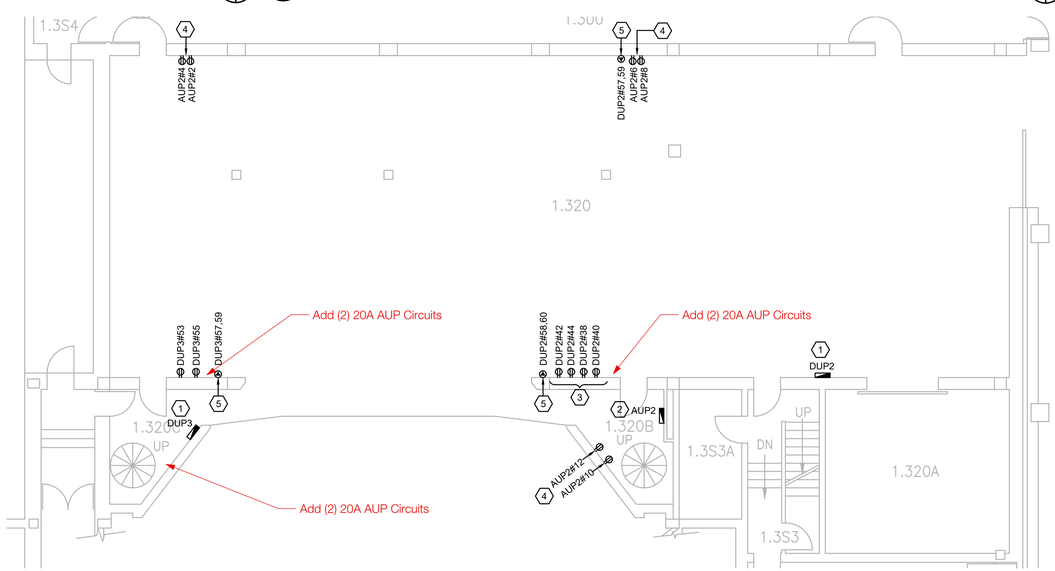


## 3 ENLARGED POWER PLAN - STAGE

1/8" = 1'-0"

## GENERAL NOTES

1. REFER TO SPECIFICATIONS, SCHEDULES, DETAILS AND GENERAL NOTES SHEET FOR ADDITIONAL ELECTRICAL EQUIPMENT AND SYSTEM INSTALLATION REQUIREMENTS.
2. SPECIAL REQUIREMENTS SUCH AS MOUNTING ABOVE COUNTER (AC), GROUND FAULT CIRCUIT INTERRUPTERS (GFI), AND WEATHERPROOF ENCLOSURES (WP) ARE NOTED ADJACENT TO RECEPTACLES.
3. REFER TO ELECTRICAL EQUIPMENT SCHEDULE FOR DISCONNECT AND CONTROLS REQUIREMENTS.
4. CONTRACTOR SHALL PROVIDE POWER TO ALL ITEMS SHOWN FROM THE PANEL AND CIRCUIT NUMBERS THAT ARE SHOWN ADJACENT TO THE LOAD (RECEPTACLE, DISCONNECT, JBOX, EQUIPMENT CONNECTION POINT, ETC). SIZE CIRCUIT PER PANEL SCHEDULE. PROVIDE NEUTRAL AND GROUND, U.N.O.
5. ALL JUNCTION BOXES SHALL BE LABELED WITH THE BRANCH CIRCUIT NUMBERS AND THEIR PANEL ORIGINATIONS.
6. ALL OUTLETS, INCLUDING RECEPTACLES AND SWITCHES SHALL BE LABELED WITH THE BRANCH CIRCUIT NUMBERS AND THEIR PANEL ORIGINATIONS.

## KEYED NOTES: (X)

1. PANEL IS EXISTING TO REMAIN.
2. SURFACE MOUNT NEW PANEL 'AUP2'. CONNECT TO EXISTING 100A/3P SPARE BREAKER IN PANEL 'BDLY'. FEEDER SHALL CONSIST OF 4#1, 1#8G., 1-1/2"C.
3. PROVIDE FOUR (4) DEDICATED 20A, 120V CIRCUITS; AND ONE (1) DEDICATED 20A, 208V, 1-PHASE CIRCUIT (NEMA L6-20R) FOR EQUIPMENT POWER AT THIS LOCATION. EXACT LOCATION AND NEMA CONFIGURATIONS TO BE DETERMINED BY OWNER. CIRCUIT AS INDICATED.
4. PROVIDE TWO (2) DEDICATED 20A, 120V CIRCUITS FOR AUDIO EQUIPMENT POWER. CIRCUIT AS INDICATED.
5. PROVIDE A DEDICATED 20A, 208V, 1-PHASE CIRCUITS FOR EQUIPMENT POWER AT STAGE. PROVIDE NEMA L6-20R RECEPTACLE. VERIFY NEMA CONFIGURATION AND EXACT PLACEMENT WITH OWNER. PROVIDE NEW 20A/2P CIRCUIT BREAKER IN EXISTING AVAILABLE SPACES IN PANEL AS INDICATED. MATCH EXISTING MANUFACTURER AND AIC RATING.


EEA CONSULTING ENGINEERS
6615 Vaught Ranch Road, Suite 100
Austin, Texas 78730-2314 USA
512.744.4400 main - 512.744.4444 fax
www.eeace.com

State of registration TEXAS
Firm Registration No.F-2497
EEA Project No.20180134


ISSUE DATE: 02.28.2019

DATE: 02.28.2019
DRAWN BY: SLB
CHECKED BY: JCW
APPROVED BY: JCW

PROJECT TEAM

| | |
|---|---|
| ARCHITECT | HCA |
| FIRE. ENGR. | |
| MECH. ENGR. | EEA |
| ELEC. ENGR. | EEA |
| INT. DESIGNER | |
| ACOUST. ENG. | |
| CONS. INSP. | |
| OTHER | |

REVISIONS

| NO | DATE: | DESCRIPTION |
|---|---|---|
| | | |

FL. WINSHIP DRAMA BUILDING
PAYNE THEATRE UPGRADES
CP738669

PROJECT MANAGEMENT & CONSTRUCTION SERVICES
PROJECT SUPPORT

KAREN LACEY — PROJECT MANAGER
CP# 738669
100% CONSTRUCTION DOCUMENTS — PHASE
CLIENT APPROVAL — DATE

THE UNIVERSITY OF TEXAS AT AUSTIN

Digitally Signed
STATE OF TEXAS — JARED C WINN — 116423 — LICENSED PROFESSIONAL ENGINEER
Jared Winn, PE (TX)
2019.02.28 16:31:22-06'00'

PROJECT NUMBER: 738669

SHEET: E2.0

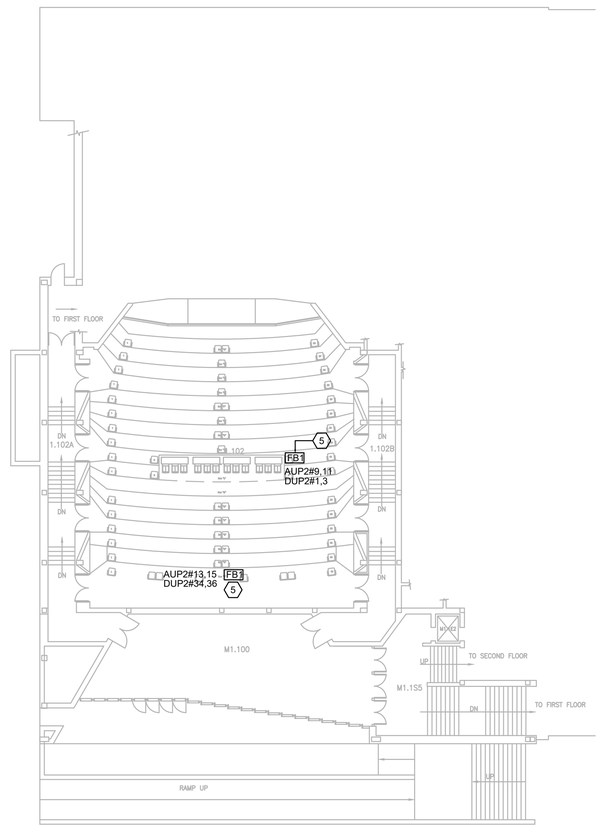


## 1 POWER PLAN - 1ST FLOOR MEZZ

1/16" = 1'-0"

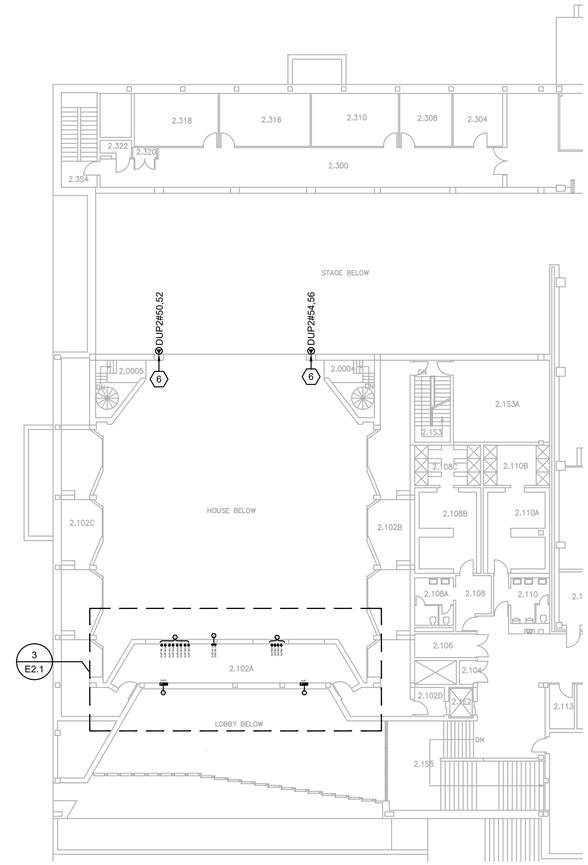


## 2 POWER PLAN - 2ND FLOOR

1/16" = 1'-0"

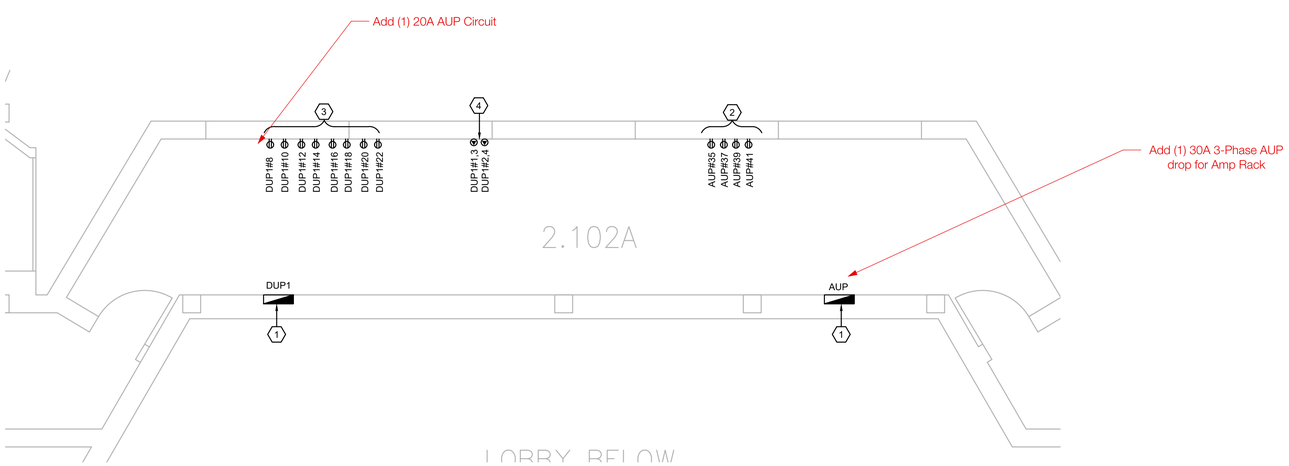


## 3 ENLARGED POWER PLAN - CONTROL BOOTH

1/4" = 1'-0"

## GENERAL NOTES

1. REFER TO SPECIFICATIONS, SCHEDULES, DETAILS AND GENERAL NOTES SHEET FOR ADDITIONAL ELECTRICAL EQUIPMENT AND SYSTEM INSTALLATION REQUIREMENTS.
2. SPECIAL REQUIREMENTS SUCH AS MOUNTING ABOVE COUNTER (AC), GROUND FAULT CIRCUIT INTERRUPTERS (GFI), AND WEATHERPROOF ENCLOSURES (WP) ARE NOTED ADJACENT TO RECEPTACLES.
3. REFER TO ELECTRICAL EQUIPMENT SCHEDULE FOR DISCONNECT AND CONTROLS REQUIREMENTS.
4. CONTRACTOR SHALL PROVIDE POWER TO ALL ITEMS SHOWN FROM THE PANEL AND CIRCUIT NUMBERS THAT ARE SHOWN ADJACENT TO THE LOAD (RECEPTACLE, DISCONNECT, JBOX, EQUIPMENT CONNECTION POINT, ETC). SIZE CIRCUIT PER PANEL SCHEDULE. PROVIDE NEUTRAL AND GROUND, U.N.O.
5. ALL JUNCTION BOXES SHALL BE LABELED WITH THE BRANCH CIRCUIT NUMBERS AND THEIR PANEL ORIGINATIONS.
6. ALL OUTLETS, INCLUDING RECEPTACLES AND SWITCHES SHALL BE LABELED WITH THE BRANCH CIRCUIT NUMBERS AND THEIR PANEL ORIGINATIONS.

## KEYED NOTES: (X)

1. EXISTING PANEL TO REMAIN.
2. PROVIDE FOUR (4) DEDICATED 20A, 120V CIRCUITS FOR AUDIO EQUIPMENT POWER. EXACT LOCATION WITHIN CONTROL BOOTH TO BE DETERMINED BY OWNER. CIRCUIT TO EXISTING 20A/1P SPARE CIRCUIT BREAKERS IN PANEL 'AUP'.
3. PROVIDE EIGHT (8) DEDICATED 20A, 120V CIRCUITS FOR IM & STAGE MANAGEMENT EQUIPMENT POWER. EXACT LOCATION WITHIN CONTROL BOOTH TO BE DETERMINED BY OWNER. CIRCUIT TO EXISTING 20A/1P SPARE CIRCUIT BREAKERS IN PANEL 'DUP1'.
4. PROVIDE TWO (2) DEDICATED 20A, 208V, 1-PHASE CIRCUITS FOR PROJECTOR POWER. PROVIDE NEMA L6-20R RECEPTACLE. VERIFY NEMA CONFIGURATION AND EXACT PLACEMENT WITH OWNER. REMOVE FOUR (4) EXISTING 20A/1P CIRCUIT BREAKERS FROM PANEL 'DUP1' AND REPLACE WITH TWO (2) NEW 20A/2P CIRCUIT BREAKERS. MATCH EXISTING MANUFACTURER AND AIC RATING.
5. PROVIDE NEW HIGH CAPACITY FLOOR BOX. PROVIDE SPLIT WIRE DEDICATED RECEPTACLE FOR AUDIO POWER CIRCUITED TO PANEL 'AUP2'; AND SPLIT WIRE DEDICATED RECEPTACLE CIRCUITED TO PANEL DUP2.
6. PROVIDE DEDICATED 20A, 208V, 1-PHASE CIRCUIT FOR PROJECTOR POWER AT FLY RAIL. PROVIDE NEMA L6-20R RECEPTACLE. VERIFY NEMA CONFIGURATION AND EXACT PLACEMENT WITH OWNER. PROVIDE NEW 20A/2P CIRCUIT BREAKER IN EXISTING AVAILABLE SPACES IN PANEL 'DUP2'. MATCH EXISTING MANUFACTURER AND AIC RATING.


EEA CONSULTING ENGINEERS
6615 Vaught Ranch Road, Suite 100
Austin, Texas 78730-2314 USA
512.744.4400 main - 512.744.4444 fax
www.eeace.com

State of registration TEXAS
Firm Registration No.F-2497
EEA Project No. 20180134


ISSUE DATE: 02.28.2019

DATE: 02.28.2019
DRAWN BY: SLB
CHECKED BY: JCW
APPROVED BY: JCW

PROJECT TEAM

| | |
|---|---|
| ARCHITECT | HCA |
| FIRE. ENGR. | |
| MECH. ENGR. | EEA |
| ELEC. ENGR. | EEA |
| INT. DESIGNER | |
| A/V DESIGN. | |
| CONS. INSP. | |
| OTHER | |

REVISIONS

| NO | DATE: | DESCRIPTION |
|---|---|---|
| | | |

FL. WINSHIP DRAMA BUILDING
PAYNE THEATRE UPGRADES
CP738669

PROJECT MANAGEMENT & CONSTRUCTION SERVICES
PROJECT SUPPORT

KAREN LAGEY CP# 738669
PROJECT MANAGER
100% CONSTRUCTION DOCUMENTS
PHASE
CLIENT APPROVAL DATE

THE UNIVERSITY OF TEXAS AT AUSTIN

Digitally Signed

STATE OF TEXAS
JARED C WINN
116423
LICENSED
PROFESSIONAL ENGINEER

Jared Winn, PE (TX)
2019.02.28 16:31:17-06'00'

PROJECT NUMBER: 738669

SHEET: E2.1

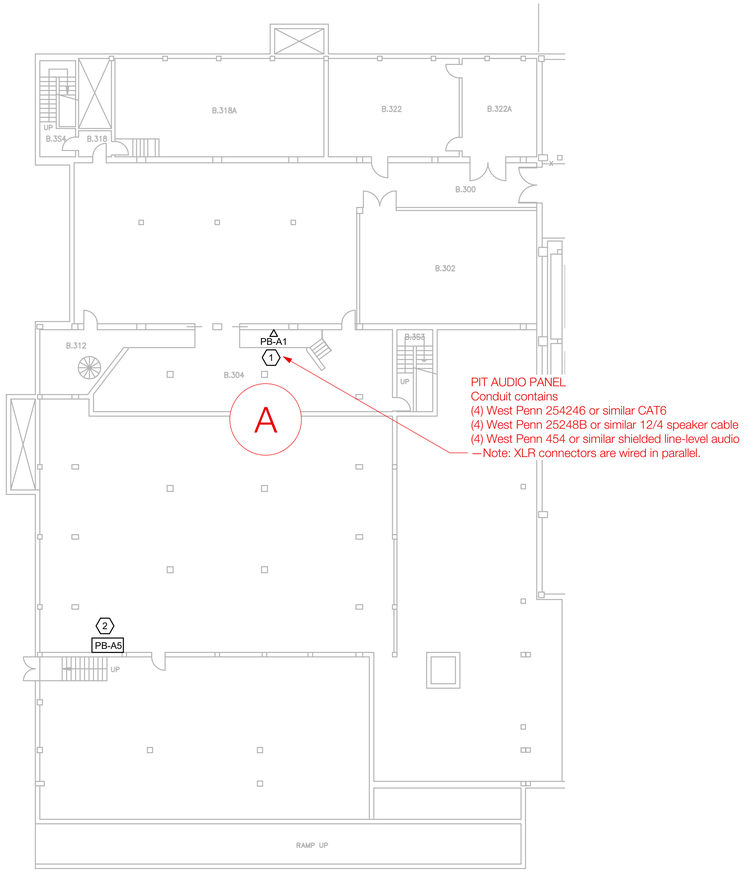


N 1 **AUDIO SYSTEMS PLAN - BASEMENT**
1/16" = 1'-0"

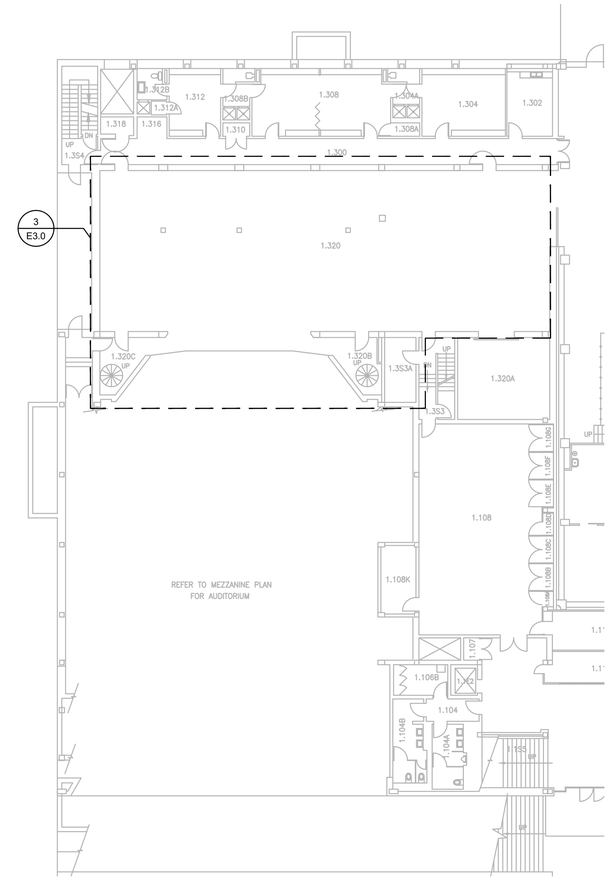


N 2 **AUDIO SYSTEMS PLAN - 1ST FLOOR**
1/16" = 1'-0"

## GENERAL NOTES

1. REFER TO SPECIFICATIONS, SCHEDULES, DETAILS AND GENERAL NOTES SHEET FOR ADDITIONAL SPECIAL SYSTEMS INSTALLATION REQUIREMENTS.
2. SPECIAL REQUIREMENTS SUCH AS MOUNTING ABOVE COUNTER (AC), ETC ARE NOTED ADJACENT TO DATA OUTLETS.
3. EC'S SCOPE INCLUDES RACEWAY INFRASTRUCTURE FOR ALL ITEMS SHOWN ON THE SPECIAL SYSTEMS PLANS. RACEWAY REQUIREMENTS ARE DEFINED IN SPECIFICATION NOTES AND DETAILS, BUT SHALL BE FIELD VERIFIED BEFORE WORK.
4. ALL IT CABLING, JACKS, EQUIPMENT RACKS, A/V AND NETWORKING EQUIPMENT WILL BE PROVIDED AND INSTALLED BY OTHERS. EC RESPONSIBLE FOR ALL ROUGH IN WORK AND POWER CONNECTIONS.
5. COORDINATE TELECOMMUNICATIONS INFRASTRUCTURE REQUIREMENTS WITH OWNER'S IT REPRESENTATIVE PRIOR TO STARTING WORK.
6. PROVIDE 4"x4" SQUARE PULL BOXES AT EACH 90° IN THE IT AND AV CONDUIT RUNS.
7. CONDUIT PATHWAYS FROM STAGE TO BOOTH OR EITHER FLOOR BOX TO BOOTH MUST NOT SUM THE GREATER THAN 225 FEET.
8. PROVIDE PULL STRING IN ALL CONDUITS.

## KEYED NOTES: (X)

1. PROVIDE 2-GANG BOX WITH (2) 1-1/4" CONDUITS TO PULL BOX NOTED.
2. 12"X12"X4"D PULL BOX WITH HINGED COVERPLATE.

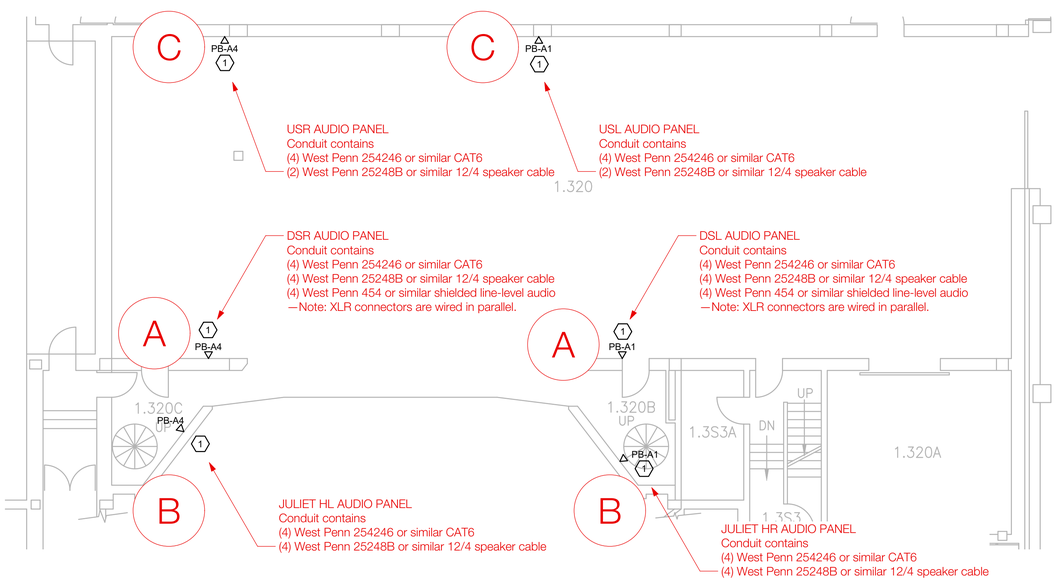


N 3 **ENLARGED AUDIO SYSTEMS PLAN - STAGE**
1/8" = 1'-0"

(x) Please refer to A-dP (Audio Detail: Panels) for panel connectors and dimensions referenced by these call-outs


EEA CONSULTING ENGINEERS
6615 Vaught Ranch Road, Suite 100
Austin, Texas 78730-2314 USA
512.744.4400 main - 512.744.4444 fax
www.eeace.com

State of registration TEXAS
Firm Registration No.F-2497
EEA Project No.20180134


ISSUE DATE: 02.28.2019

DATE: 02.28.2019
DRAWN BY: SLB
CHECKED BY: JCW
APPROVED BY: JCW

**PROJECT TEAM**

| | |
|---|---|
| ARCHITECT | HCA |
| FIRE. ENGR. | |
| MECH. ENGR. | EEA |
| ELEC. ENGR. | EEA |
| INT. DESIGN. | |
| A/V DESIGN. | |
| CONS. INSP. | |
| OTHER | |

**REVISIONS**

| NO | DATE: | DESCRIPTION |
|---|---|---|
| | | |

FL. WINSHIP DRAMA BUILDING
PAYNE THEATRE UPGRADES
CP738669

PROJECT MANAGEMENT & CONSTRUCTION SERVICES
PROJECT SUPPORT

KAREN LACEY — PROJECT MANAGER
CP# 738669
100% CONSTRUCTION DOCUMENTS — PHASE
CLIENT APPROVAL — DATE

THE UNIVERSITY OF TEXAS AT AUSTIN

Digitally Signed
STATE OF TEXAS — JARED C WINN — 116423 — LICENSED PROFESSIONAL ENGINEER
Jared Winn, PE (TX)
2019.02.28 16:31:11-06'00'

PROJECT NUMBER: 738669

SHEET: E3.0

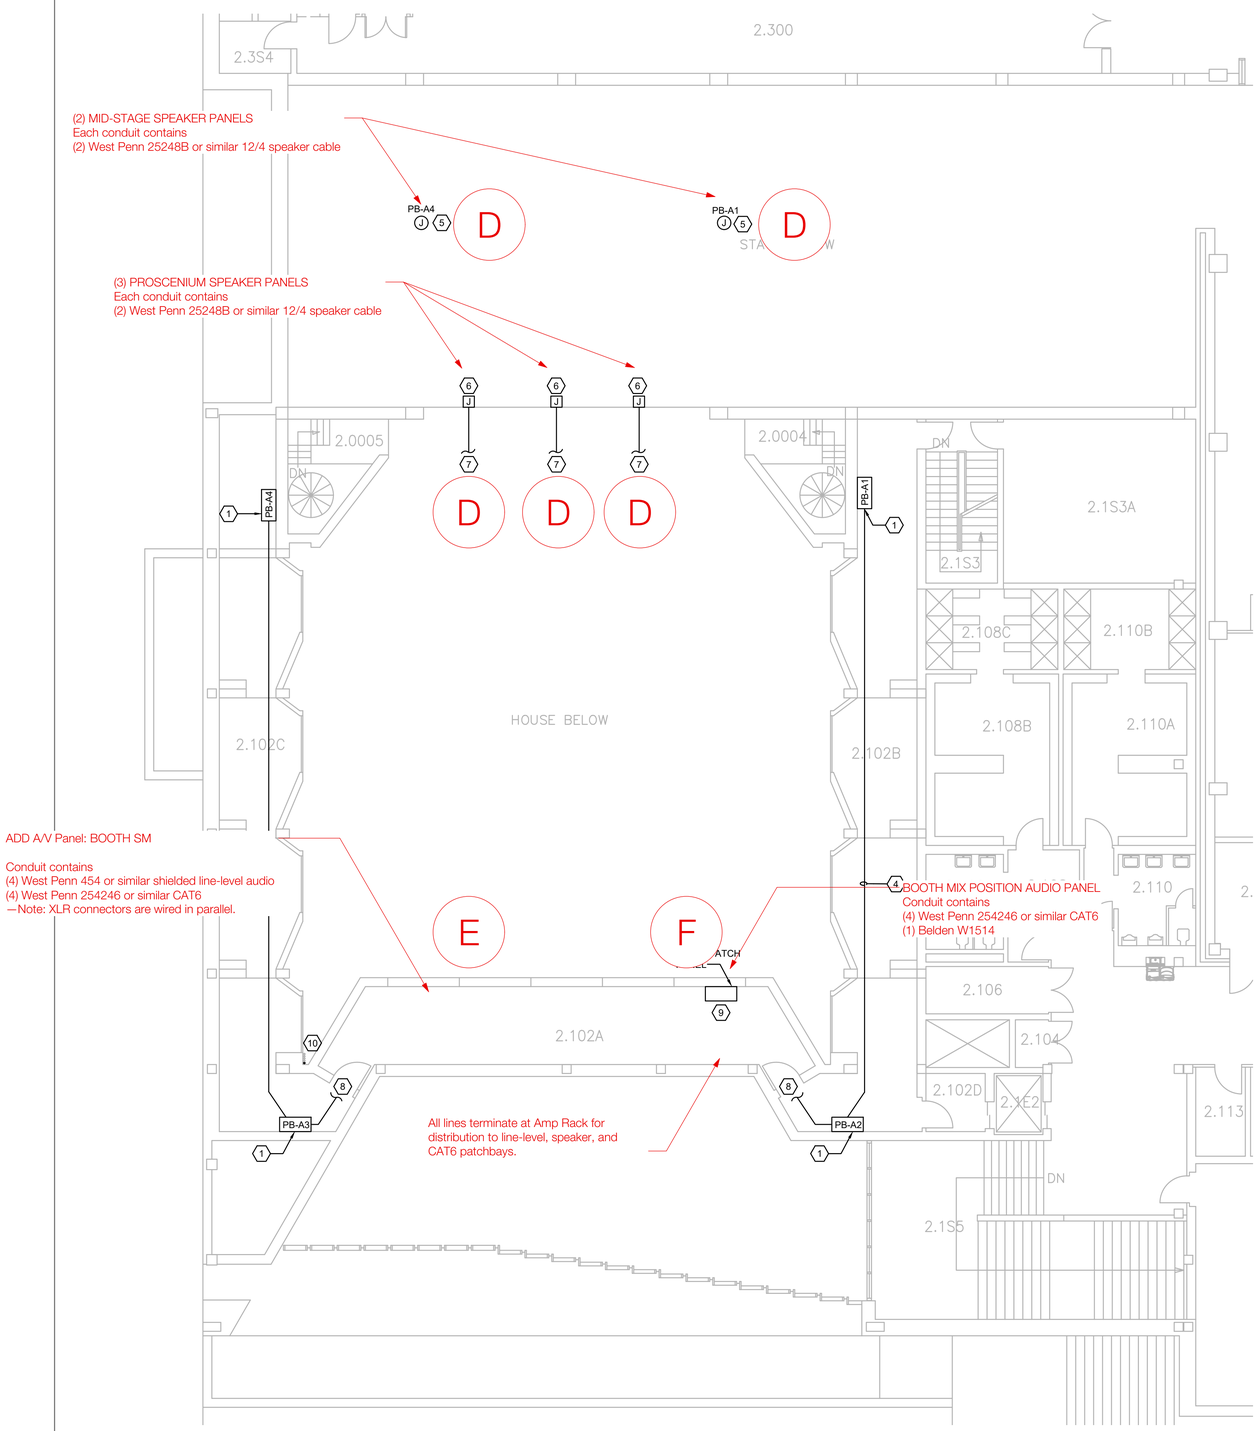


## 1 AUDIO SYSTEMS PLAN - 2ND FLOOR

1/8" = 1'-0"

## GENERAL NOTES

1. REFER TO SPECIFICATIONS, SCHEDULES, DETAILS AND GENERAL NOTES SHEET FOR ADDITIONAL SPECIAL SYSTEMS INSTALLATION REQUIREMENTS.
2. SPECIAL REQUIREMENTS SUCH AS MOUNTING ABOVE COUNTER (AC), ETC ARE NOTED ADJACENT TO DATA OUTLETS.
3. EC'S SCOPE INCLUDES RACEWAY INFRASTRUCTURE FOR ALL ITEMS SHOWN ON THE SPECIAL SYSTEMS PLANS. RACEWAY REQUIREMENTS ARE DEFINED IN SPECIFICATION NOTES AND DETAILS, BUT SHALL BE FIELD VERIFIED BEFORE WORK.
4. ALL IT CABLING, JACKS, EQUIPMENT RACKS, A/V AND NETWORKING EQUIPMENT WILL BE PROVIDED AND INSTALLED BY OTHERS. EC RESPONSIBLE FOR ALL ROUGH IN WORK AND POWER CONNECTIONS.
5. COORDINATE TELECOMMUNICATIONS INFRASTRUCTURE REQUIREMENTS WITH OWNER'S IT REPRESENTATIVE PRIOR TO STARTING WORK.
6. PROVIDE 4"x4" SQUARE PULL BOXES AT EACH 90° IN THE IT AND AV CONDUIT RUNS.
7. CONDUIT PATHWAYS FROM STAGE TO BOOTH OR EITHER FLOOR BOX TO BOOTH MUST NOT SUM THE GREATER THAN 225 FEET.
8. PROVIDE PULL STRING IN ALL CONDUITS.

## KEYED NOTES: (X)

1. 12"X12"X4"D PULL BOX WITH HINGED COVERPLATE.
2. 11-GANG CENTER FLOOR BOX. PROVIDE (1) 1-1/4" C. FROM FLOOR BOX TO TO 'PB-A5'.
3. 11-GANG REAR FLOOR BOX. PROVIDE (1) 1-1/2" C. FROM FLOOR BOX TO 'PB-A5'.
4. TWO (2) 2" CONDUITS WITH PULLWIRE. ROUTE AS INDICATED.
5. APPROXIMATE LOCATION OF AUDIO SPEAKERS AT FLY RAIL. PROVIDE (2) 1-1/4" CONDUITS TO PULL BOX NOTED. COORDINATE EXACT LOCATION AND QUANTITY REQUIRED.
6. 2-GANG BOX LOCATED AT FLY RETURN. COORDINATE EXACT LOCATION.
7. ONE (1) 1-1/4" CONDUIT WITH PULLWIRE. ROUTE TO BOOTH AS DIRECTED BY OWNER.
8. PROVIDE (2) 2" CONDUITS FROM PULLBOX TO CONTROL BOOTH AUDIO PATCH PANEL.
9. TWO (2) 2" CONDUITS FROM 'PB-A2', TWO (2) 2" CONDUITS FROM 'PB-A3', AND THREE (3) 1-1/4" CONDUITS FROM PROSCENIUM FLY RETURN TO THE TERMINATION POINT IN THE BOOTH AS DIRECTED BY OWNER.
10. PROVIDE (1) 2" CONDUIT FROM PB-A5 IN CRAWL SPACE TO AUDIO PATCH PANEL. VERTICAL CONDUIT SHALL BE RIGID STEEL AND PAINTED (COLOR TO BE SELECTED BY ARCHITECT).

(x) Please refer to A-dP (Audio Detail: Panels) for panel connectors and dimensions referenced by these call-outs

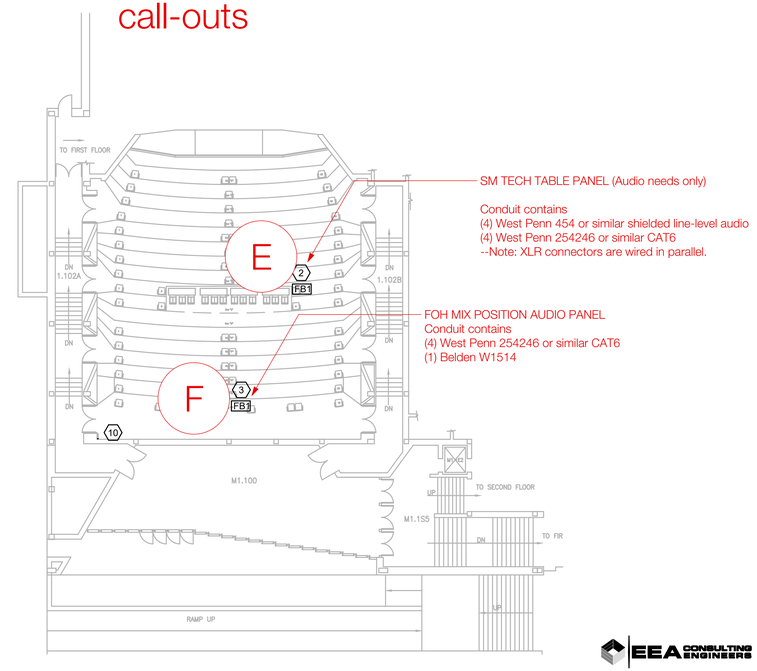


## 2 AUDIO SYSTEMS PLAN - 1ST FLOOR MEZZ

1/16" = 1'-0"

EEA CONSULTING ENGINEERS
6615 Vaught Ranch Road, Suite 100
Austin, Texas 78730-2314 USA
512.744.4400 main - 512.744.4444 fax
www.eeace.com

State of registration TEXAS
Firm Registration No.F-2497
EEA Project No. 20180134

ISSUE DATE: 02.28.2019

DATE: 02.28.2019
DRAWN BY: SLB
CHECKED BY: JCW
APPROVED BY: JCW

PROJECT TEAM

| | |
|---|---|
| ARCHITECT | HCA |
| FIRE. ENGR. | |
| MECH. ENGR. | EEA |
| ELEC. ENGR. | EEA |
| INT. DESIGNER | |
| A/V DESIGN | |
| CONS. INSP. | |
| OTHER | |

REVISIONS

| NO | DATE: | DESCRIPTION |
|---|---|---|
| | | |

FL. WINSHIP DRAMA BUILDING
PAYNE THEATRE UPGRADES
CP738669

PROJECT MANAGEMENT & CONSTRUCTION SERVICES
PROJECT SUPPORT

KAREN LAGEY — PROJECT MANAGER
CP# 738669
100% CONSTRUCTION DOCUMENTS — PHASE
CLIENT APPROVAL — DATE

THE UNIVERSITY OF TEXAS AT AUSTIN

Digitally Signed

STATE OF TEXAS — JARED C WINN — 116423 — LICENSED — PROFESSIONAL ENGINEER

Jared Winn, PE (TX)
2019.02.28 16:31:04-06'00'

PROJECT NUMBER: 738669

SHEET: E3.1